


FILE B11-25 - LOT LINE ADJUSTMENT SKETCH
Township of Southgate

BEFORE

Plan 480, Block T, Lots 15,16
 185 Gold Street


Plan 480, Block T, Lot 14
 175 Gold Street

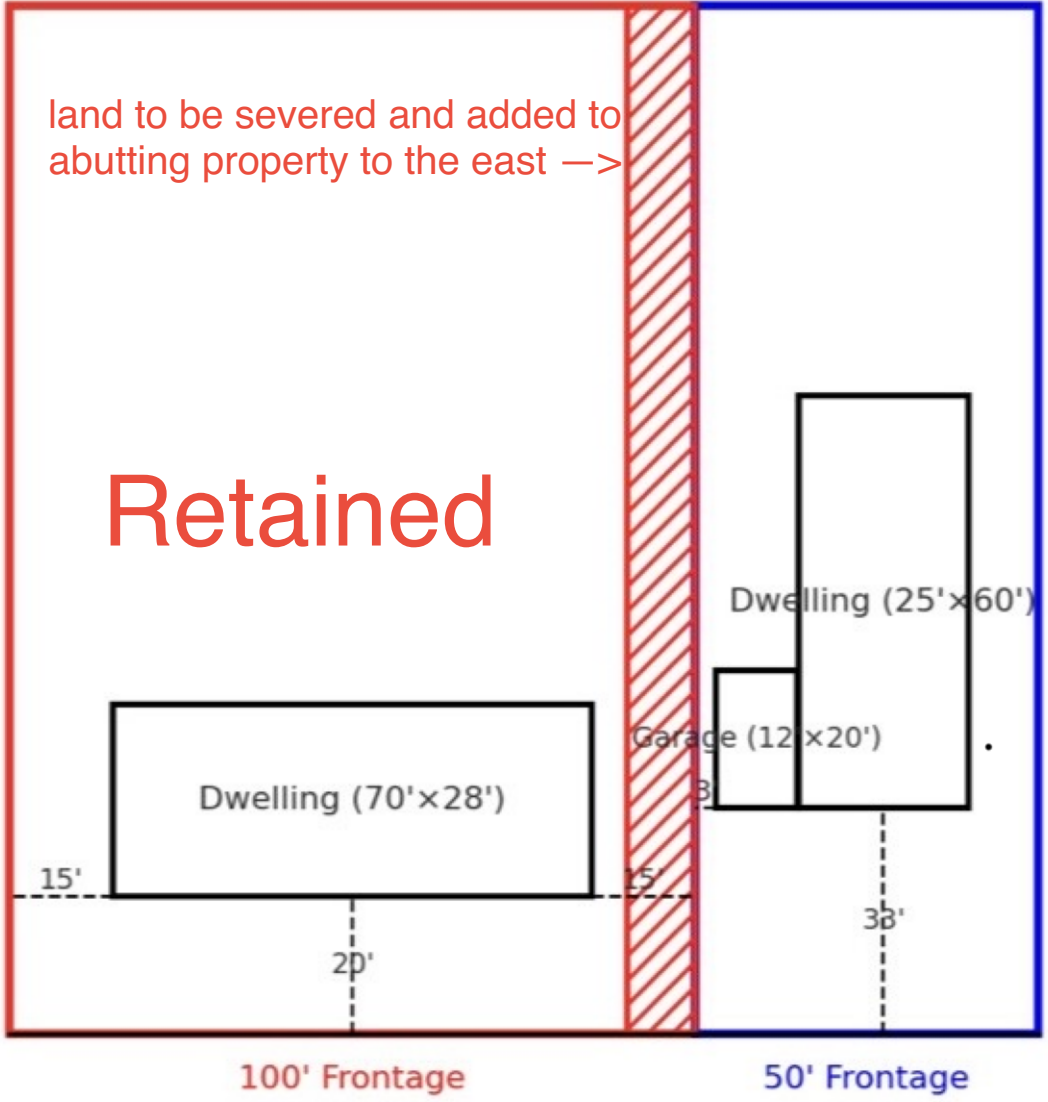

AFTER

Plan 480, Block T, Lots 15,16
 185 Gold Street

Plan 480, Block T, Lot 14
 175 Gold Street

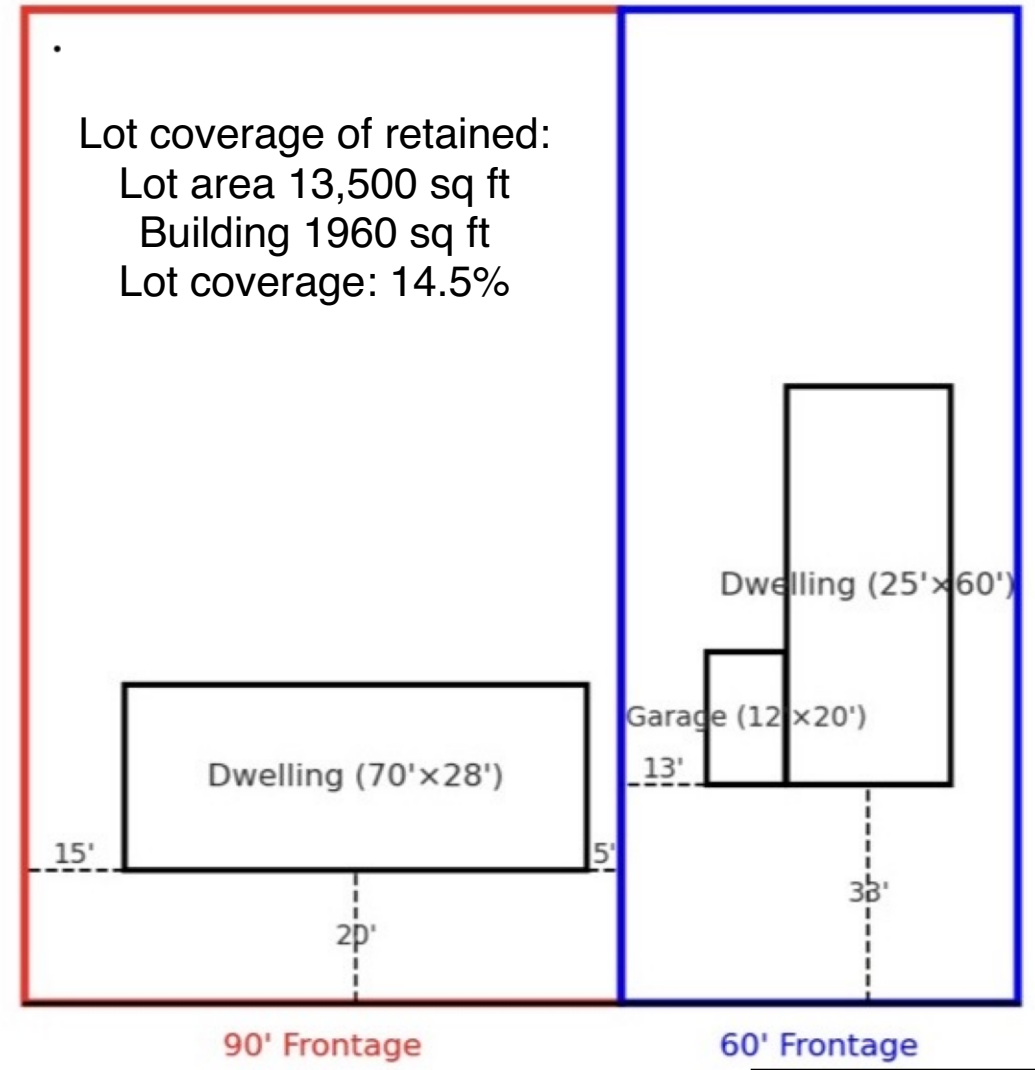

LEGEND:
 Red Line - 185 Gold St. (West Parcel)
 Blue Line - 175 Gold St. (East Parcel)
 //// - 10' Strip to be Severed
 - - - Measurement / Setback Line